


©2011 Michael R. Berta AIA Architecture & Planning. All Rights Reserved. Any use or reproduction, in whole or in part, without the written authorization of Michael R. Berta AIA is prohibited.

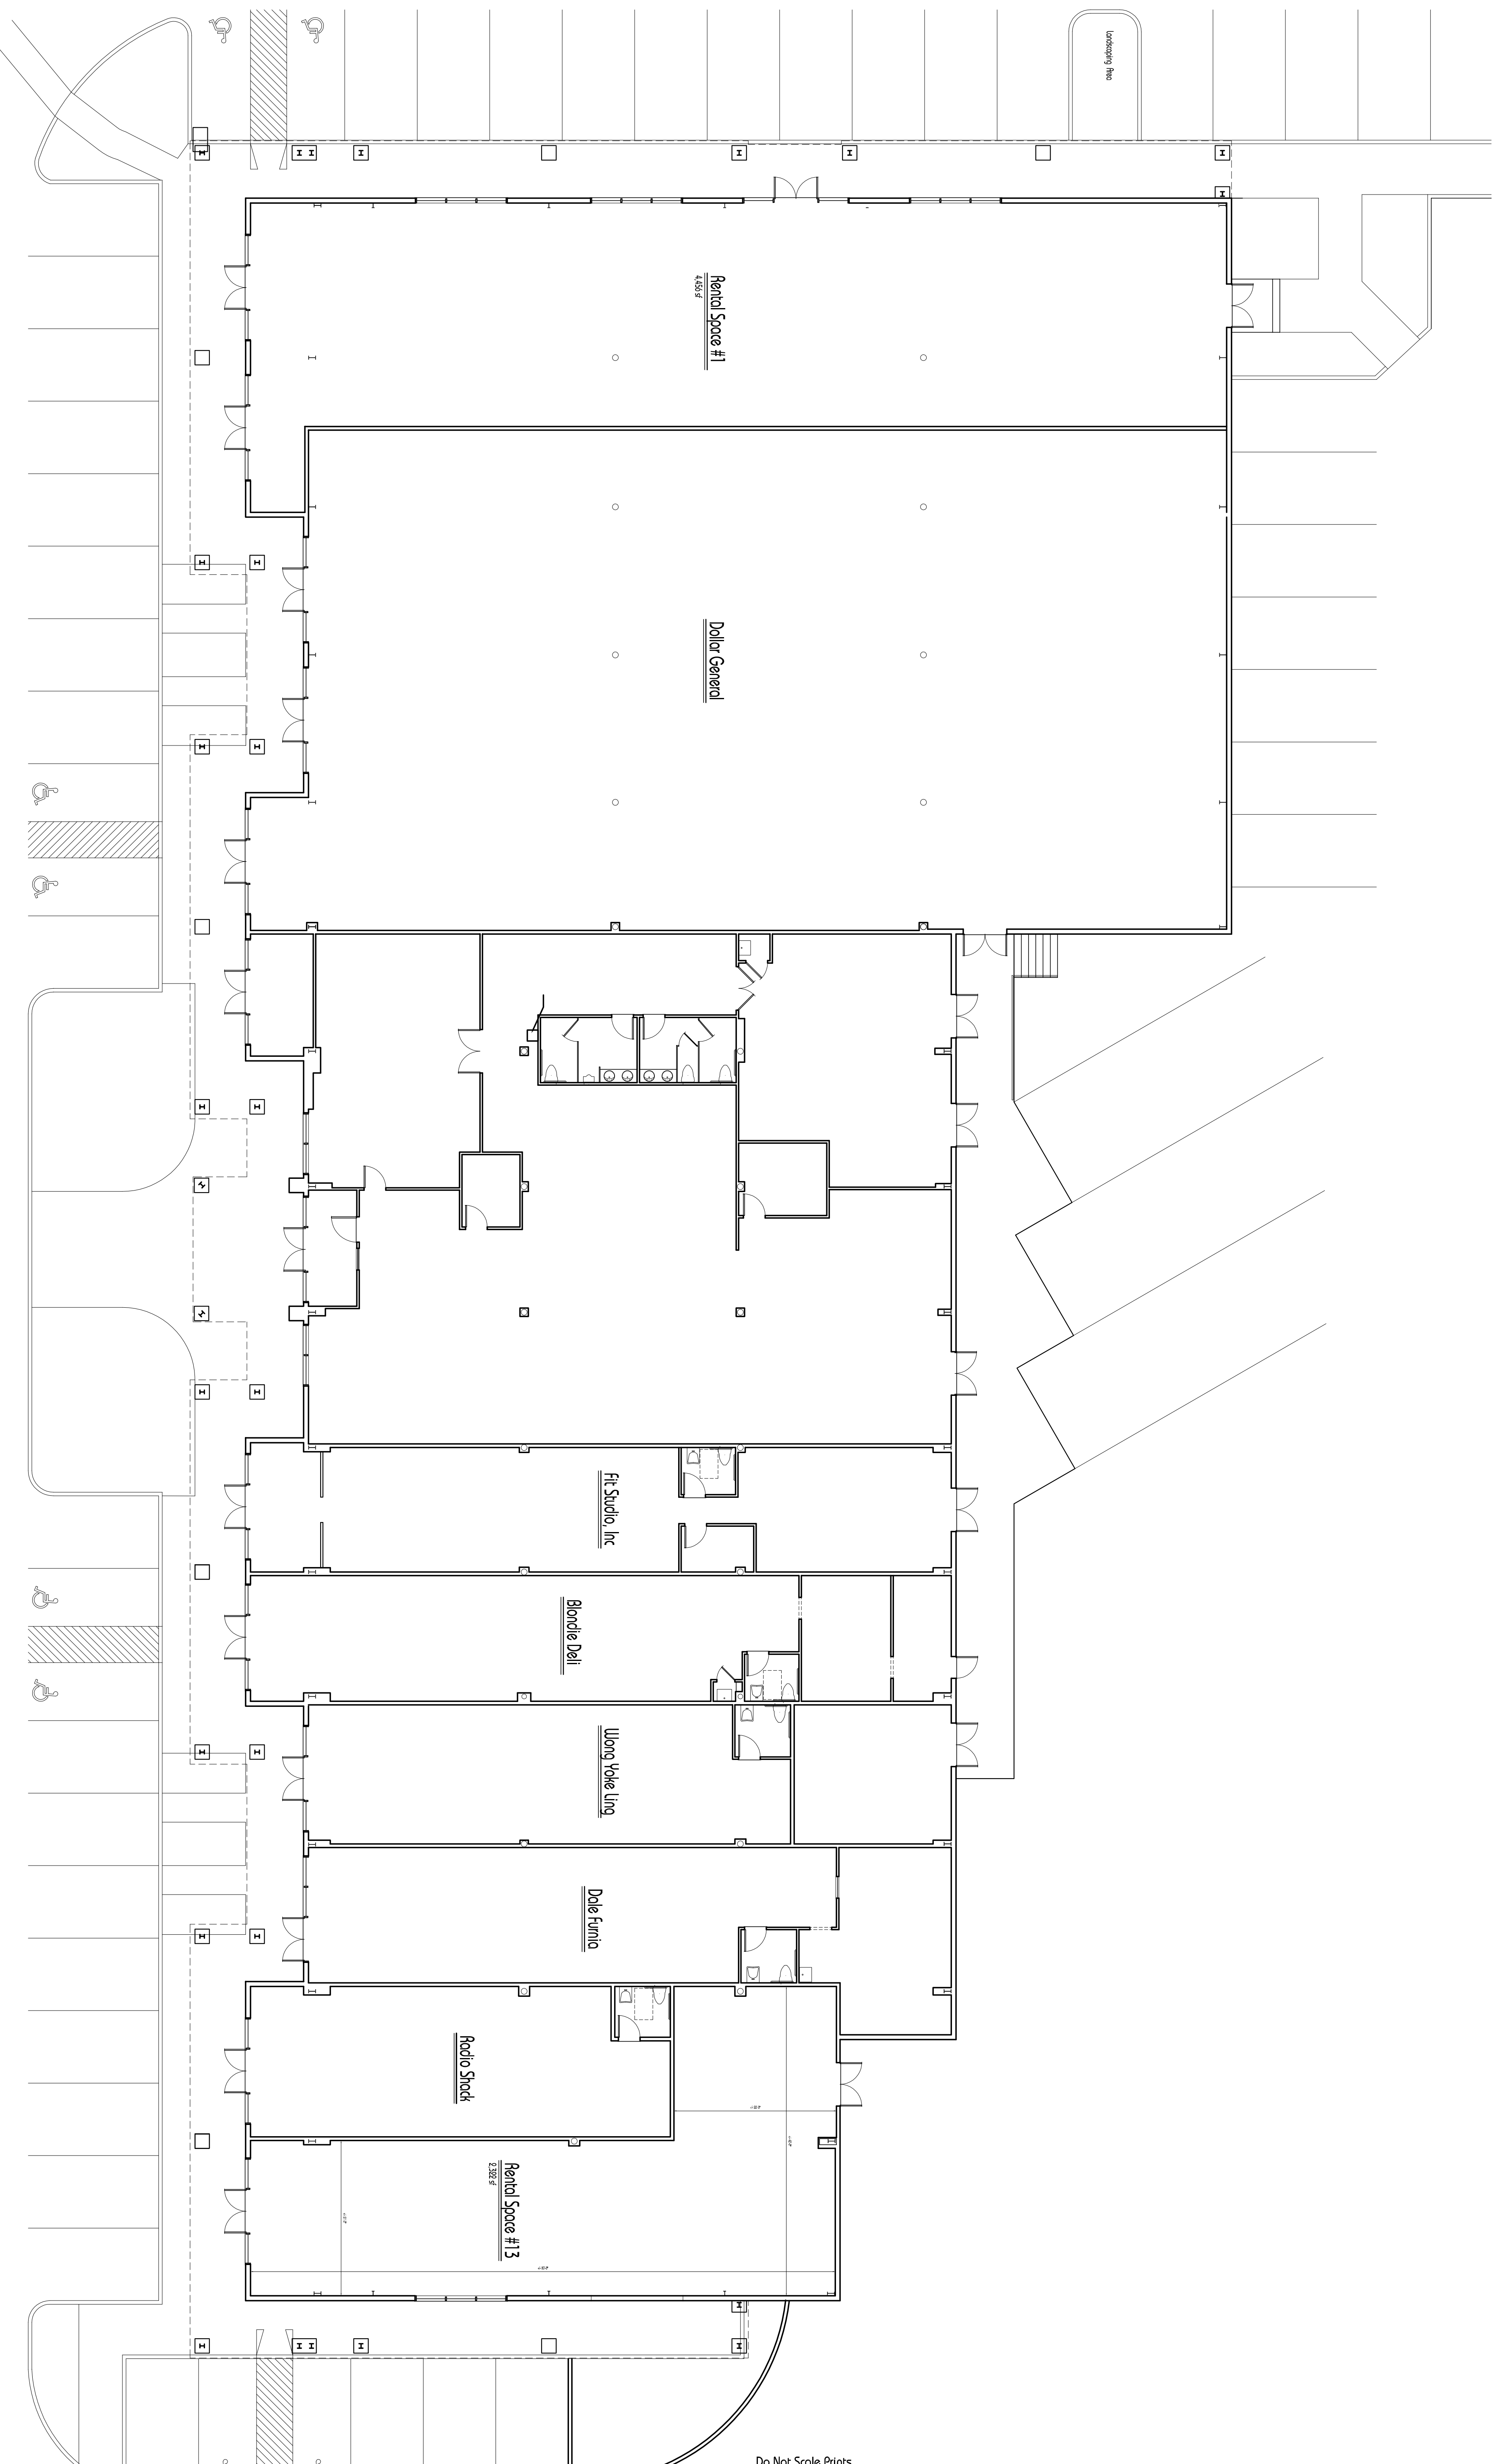

Do Not Scale Prints

Note:
It is a violation of the law for any person, unless authorized in writing by the architect, to alter or add to these plans. If any person makes any change to these plans, the architect's name and seal shall be placed on the drawing to indicate the change. The architect shall not be responsible for any errors or omissions in these plans, and shall not be held liable for any damages resulting from the use of these plans.

Job No	2009-012
Date	August 2, 2011
Scale	As Noted
Drawing	EX-1
Of	010

Floor Plan
As Built Floor Plans
Pawling Place, LLC
31 Route 22
Pawling, New York

Date	Revision

These plans are the property of Michael R. Berta AIA, Architect-Planner. Any use or reproduction in whole or part without the written authorization of Michael R. Berta is prohibited. Any person or corporation using plans without proper authorization will be responsible to compensate the Architect.

Michael R. Berta, AIA
Architecture & Planning

7 Robert Rd Poughkeepsie, NY 12603 (845) 489-1638
E-Mail mtdpc@aol.com Web Site www.bertaarchitects.com

These plans are not valid for a building permit unless originally signed and sealed by the Architect, and are for the construction of one house only by the person whose name appears on the plans.