


©2011 Michael R. Berta AIA Architecture & Planning. All Rights Reserved. Any use or reproduction, in whole or in part, without the written authorization of Michael R. Berta AIA is prohibited.

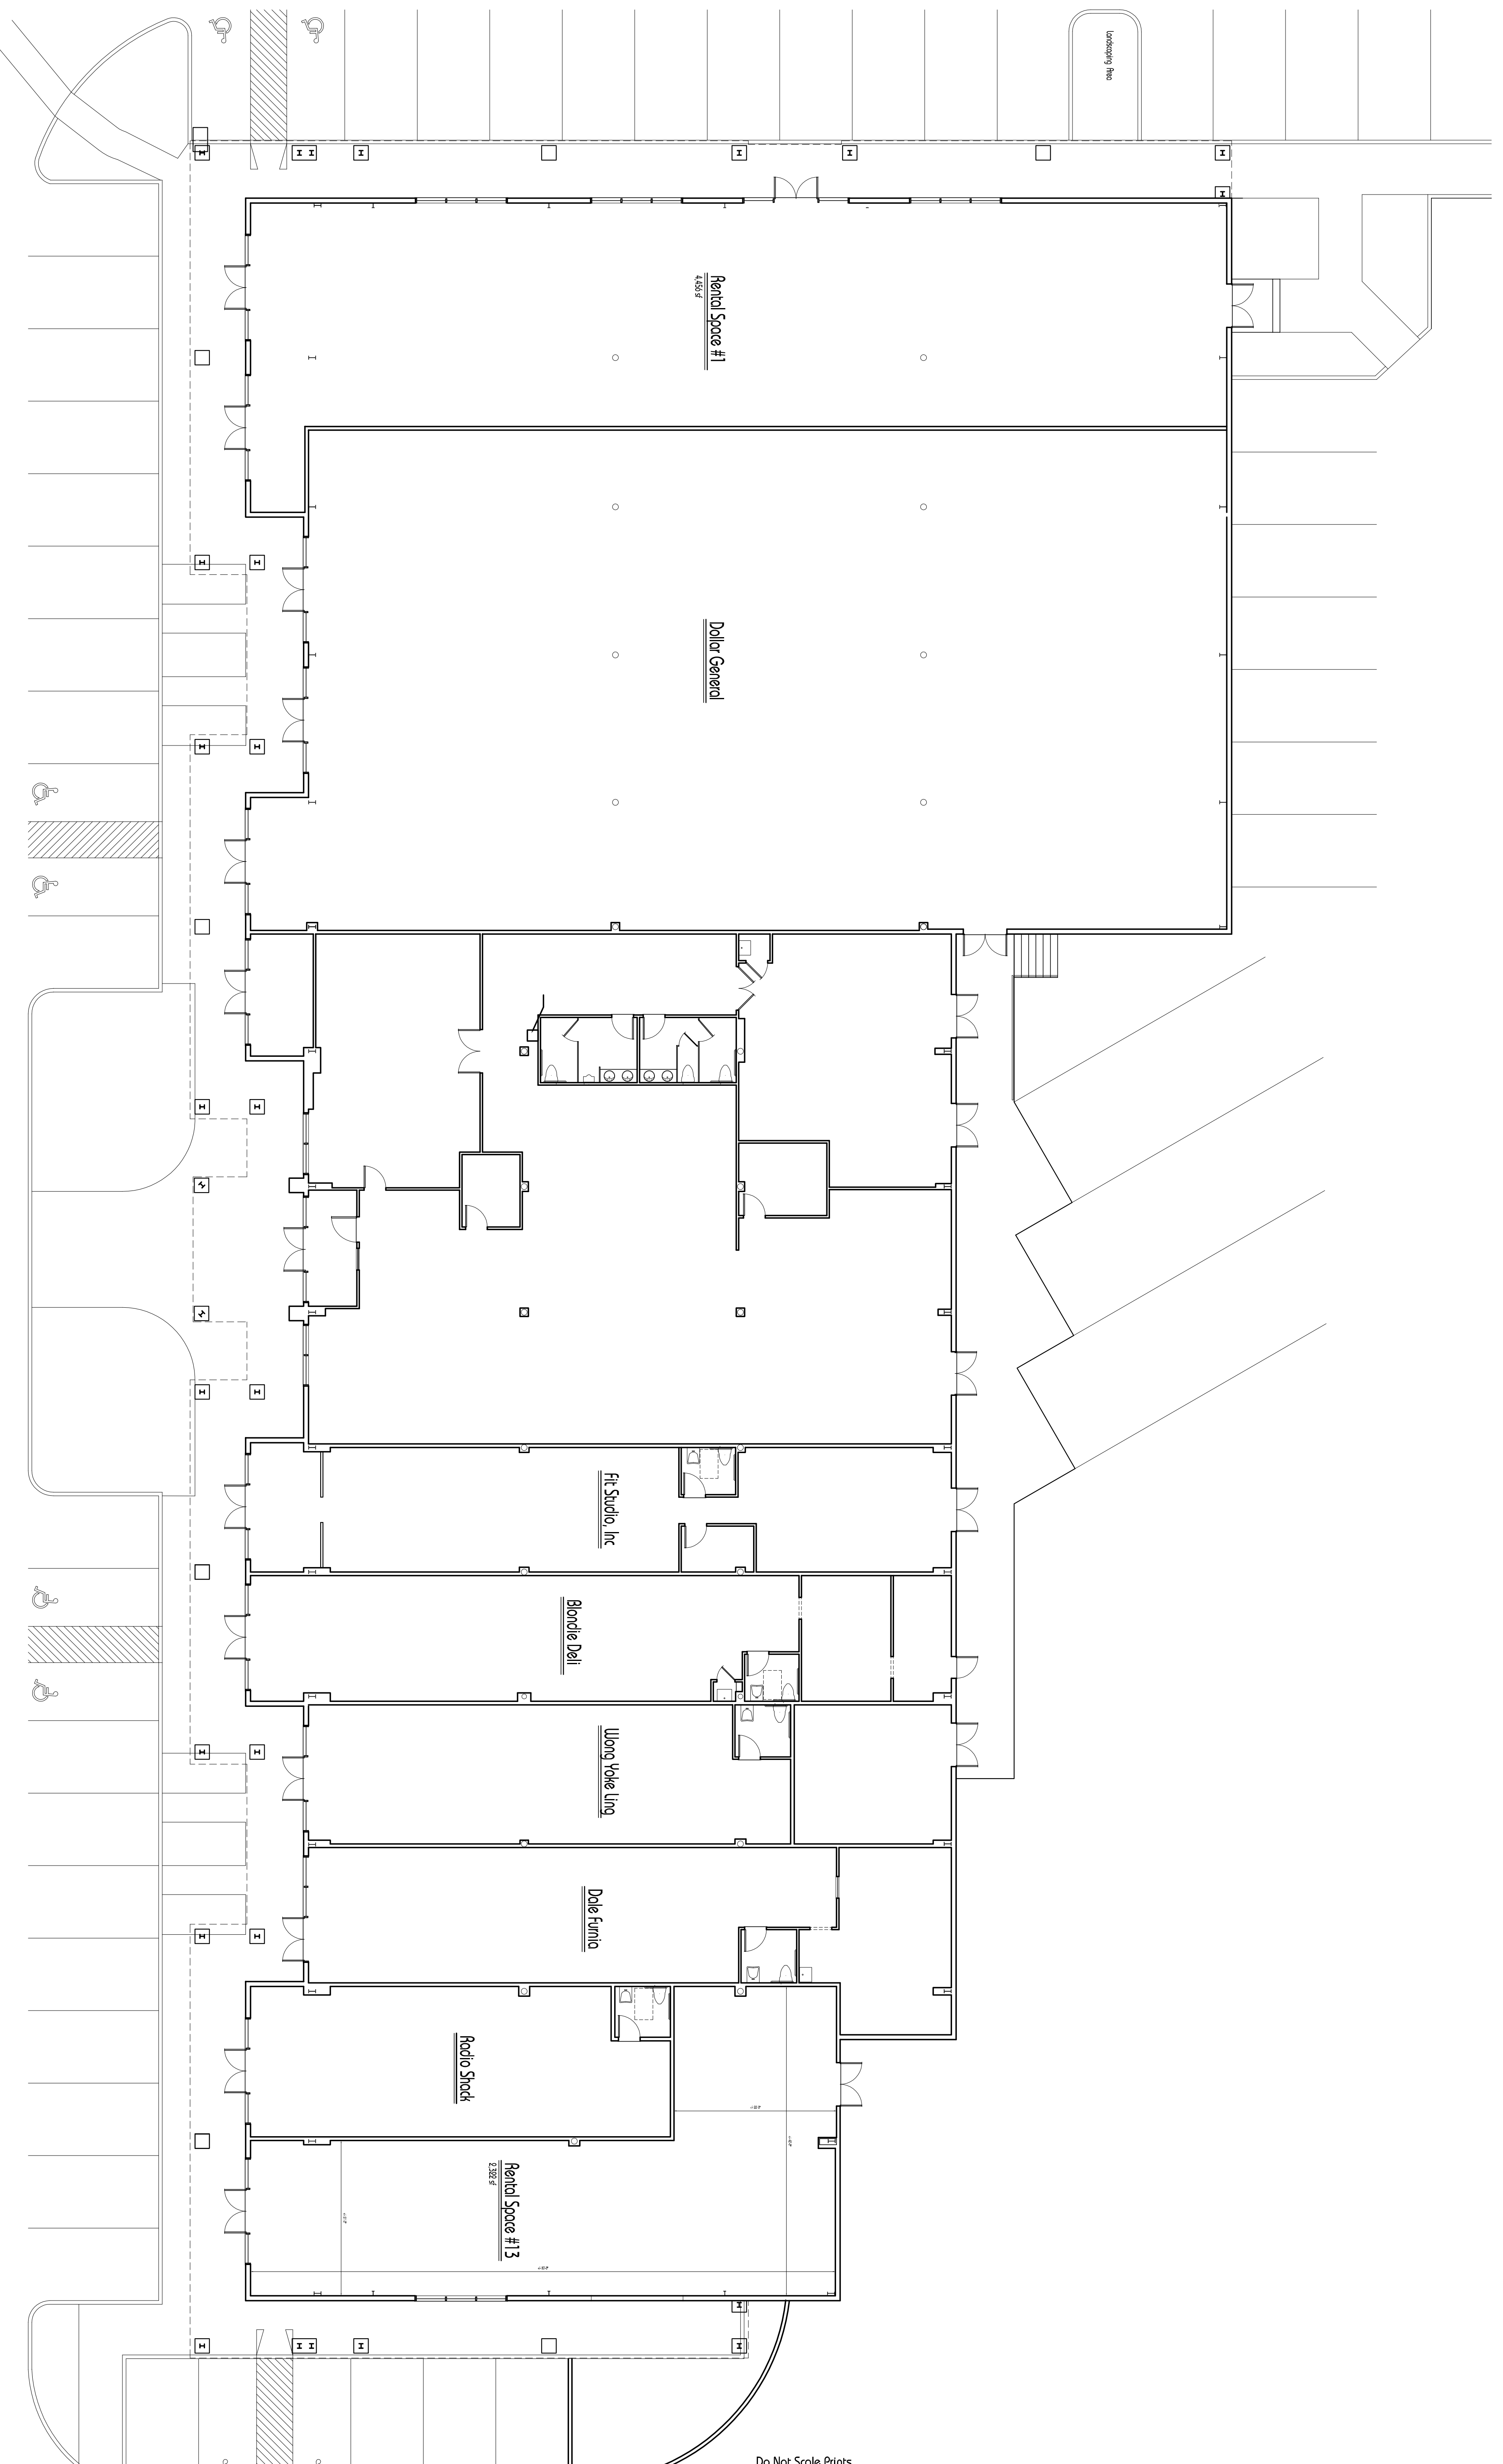

Do Not Scale Prints

Note:  
It is a violation of the law for any person, unless authorized in writing by the architect, to alter or add to these plans. Any such alteration or addition shall be at the risk of the person making the same. The architect shall not be responsible for any errors or omissions in these plans, nor for any consequences of their use. The architect's liability is limited to the design and construction of the structure as shown on these plans, and shall not extend to any other matters.

|         |                |
|---------|----------------|
| Job No  | 2009-012       |
| Date    | August 2, 2011 |
| Scale   | As Noted       |
| Drawing | EX-1           |
| Of      | 010            |

| Floor Plan  |          |
|---|----------|
| As Built Floor Plans<br><b>Pawling Place, LLC</b><br>31 Route 22<br>Pawling, New York |          |
| Date  | Revision |
|   |          |
|   |          |
These plans are the property of Michael R. Berta AIA, Architect-Planner. Any use or reproduction in whole or part without the written authorization of Michael R. Berta is prohibited. Any person or corporation using plans without proper authorization will be responsible to compensate the Architect.

**Michael R. Berta, AIA**  
Architecture & Planning

7 Robert Rd Poughkeepsie, NY 12603 (845) 489-1638  
E-Mail mtdpc@aol.com Web Site www.bertaarchitects.com

These plans are not valid for a building permit unless originally signed and sealed by the Architect, and are for the construction of one house only by the person whose name appears on the plans.